



All dimensions on the drawings must be verified against the existing site conditions before the commencement of any work.

Drawings may not be scaled.

The vertical dimensions of brickwork are based on multiple centre lines of 85mm and the contractor must set out brickwork accordingly.


The contractor is responsible for site inspections by the building inspectors of the local authorities.

Except where otherwise indicated all given levels are

The copyright of this drawing vests in the architect unless

All work must be done according to the South African Bureau of Standard's code of practice SANS 10400-2010.

REVISION	DATE	APPROVE
	REVISION	REVISION DATE

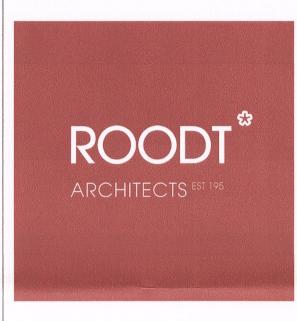

\*ARCHITECTS EST 1952

ARCHITECTURE, URBAN DESIGN, URBAN PLANNING, INTERIOR DESIGN ENVIRONMENTAL MANAGEMENT & HERITAGE CONSULTING

7 RAY CHAMPION AVENUE, LILYVALE, BLOEMFONTEIN, 9301 PO BOX 28278, DANHOF, 9310 TEL: 051 406 2100, FAX: 051 406 2101

info@roodtarchitects.co.za, www.roodtarchitects.co.za

PAN CYPRIOT CC.

RECORD DRAWINGS OF ALL STRUCTURES ON ERF 174, PRES. REITZ STREET 111 WESTDENE, BLOEMFONTEIN

TRANSPORT PLANNING PLAN

DESK	GN D	
N/A		
DRAV	VIV C	
KG	25/01/2018	
APPROVI	ED C	
SCA	ISSI	
1:100	12/W1/2018	
RECORD DRAWING STATE	US DRAWING	
DRAWINGS	1074 1/W1/07	
DIVAMINOS	10/4_1/01/0/	