



SECTION A-A
SCALE 1:50

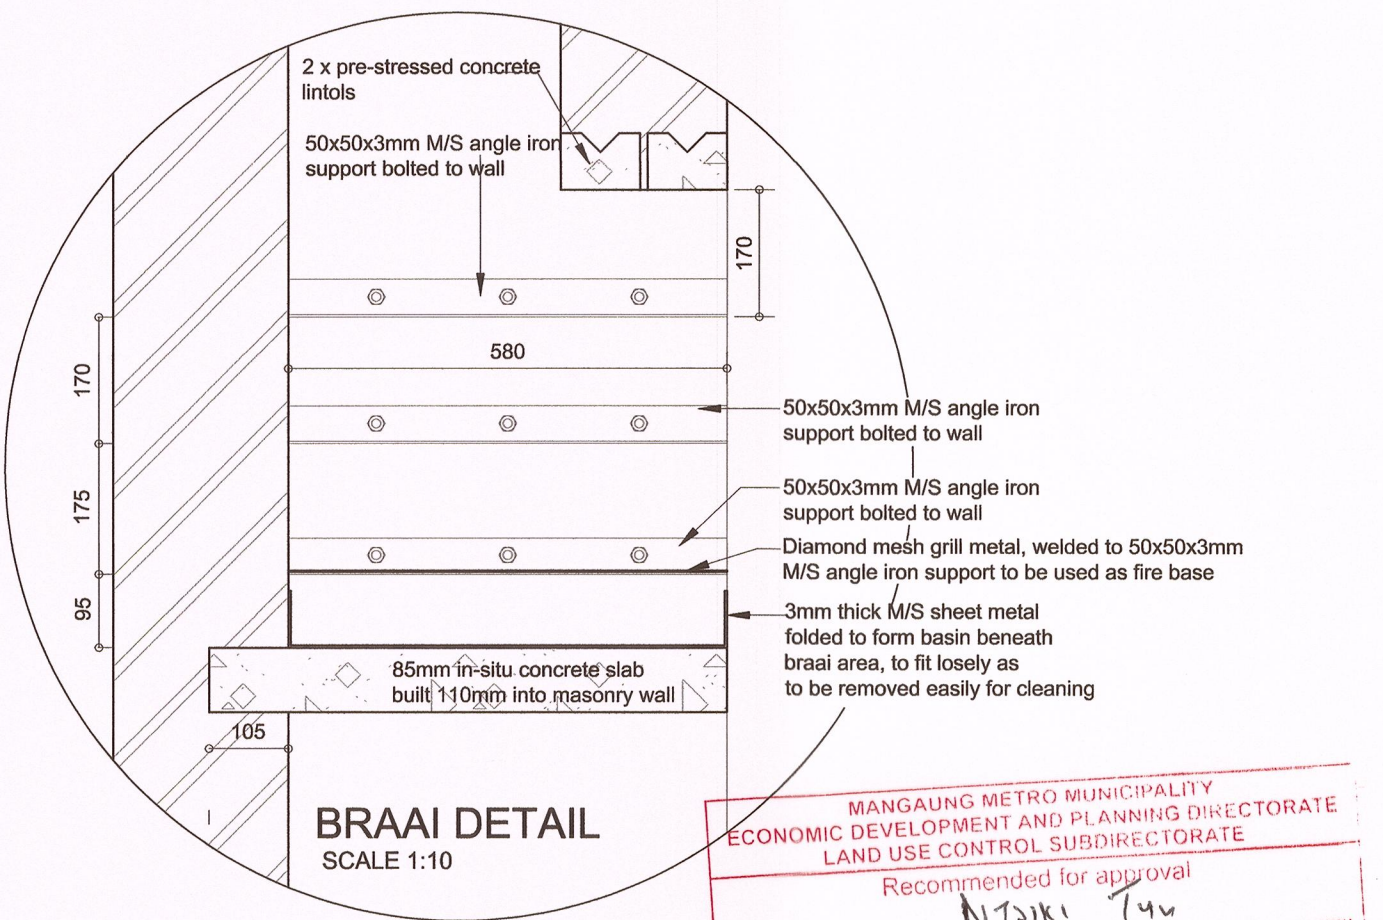


BRAAI DETAIL
SCALE 1:10


MANGAUNG METRO MUNICIPALITY
ECONOMIC DEVELOPMENT AND PLANNING DIRECTORATE
LAND USE CONTROL SUBDIRECTORATE
Recommended for approval
Ntshiki Tshu
Building Control Officer / Registered
This application has been approved in terms of
Section 7(1)(a) of Act 103 of 1977 subject to the
conditions in the attached letter of recommendation.
30/10/2018
GENERAL MANAGER: LAND USE CONTROL DATE
PLAN NO. 824/2010-2014

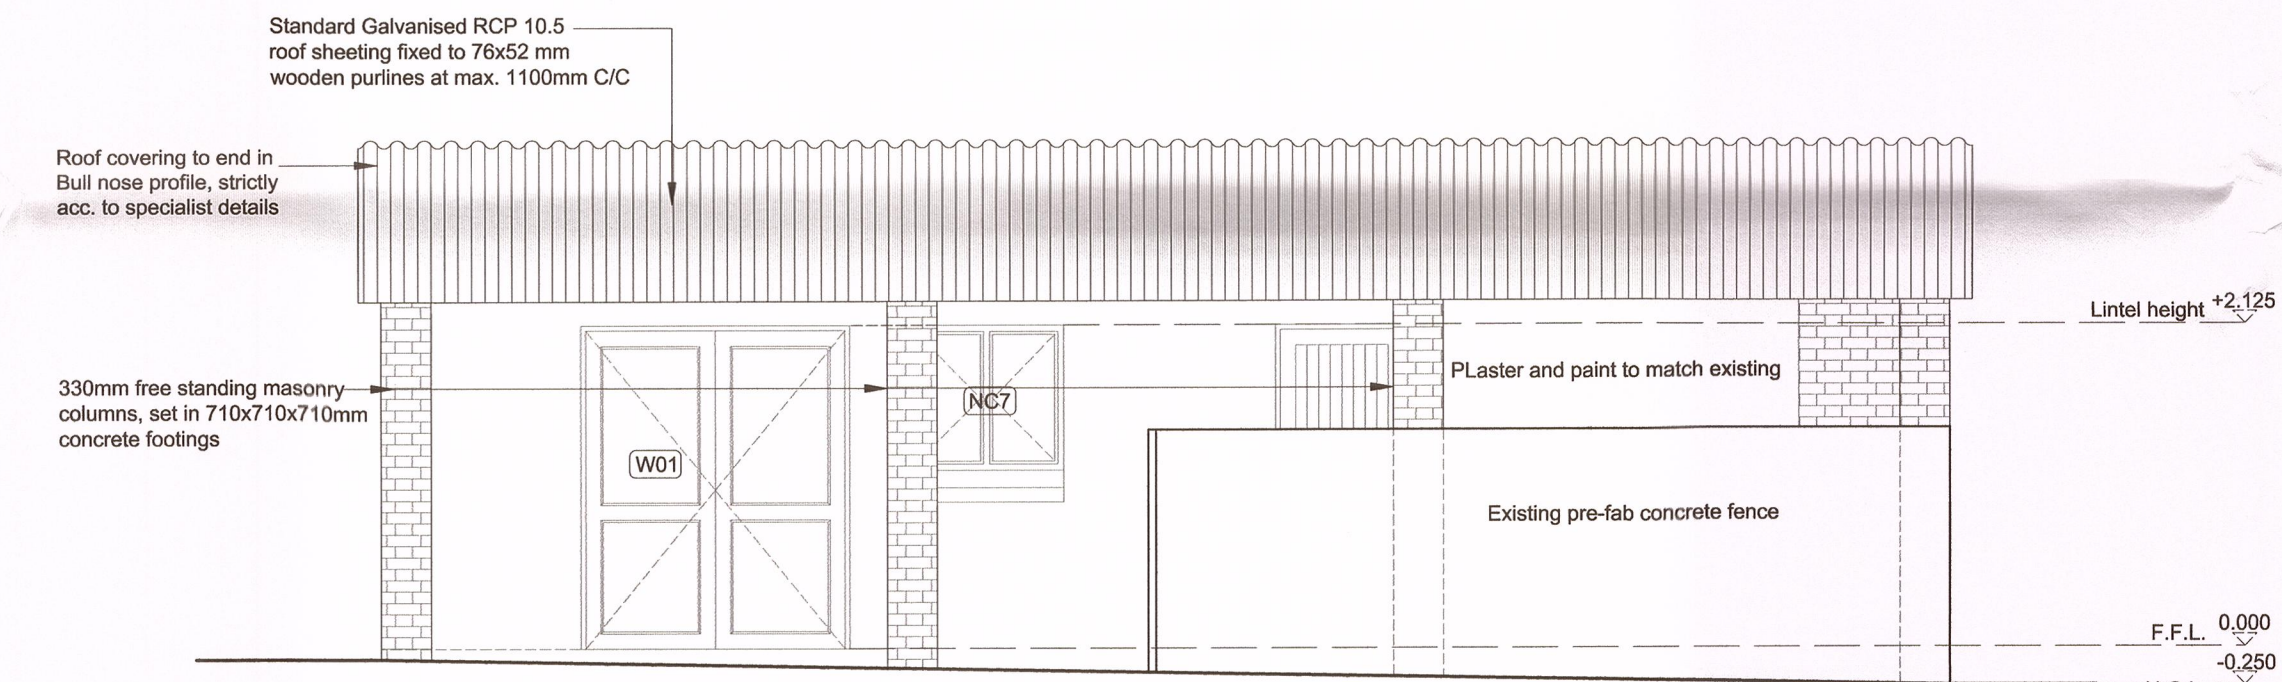


NORTH ELEVATION
SCALE 1:50

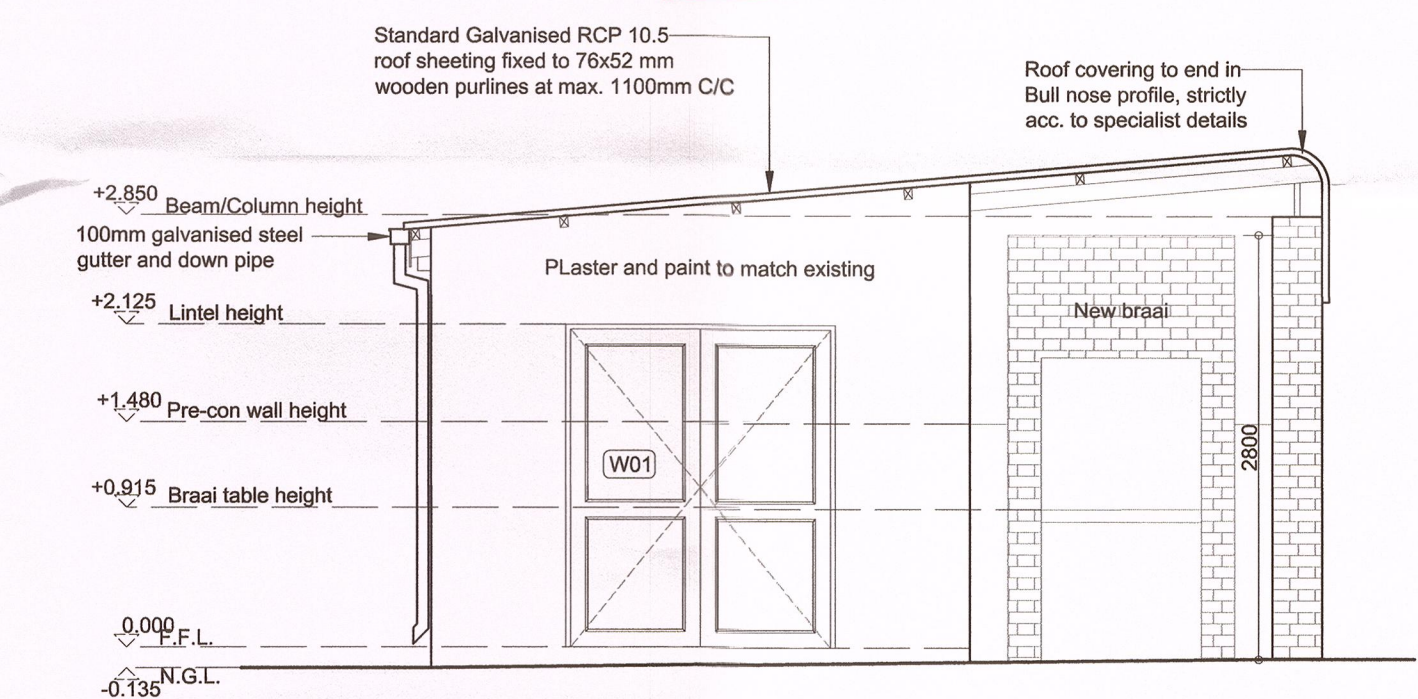

EAST ELEVATION
SCALE 1:50

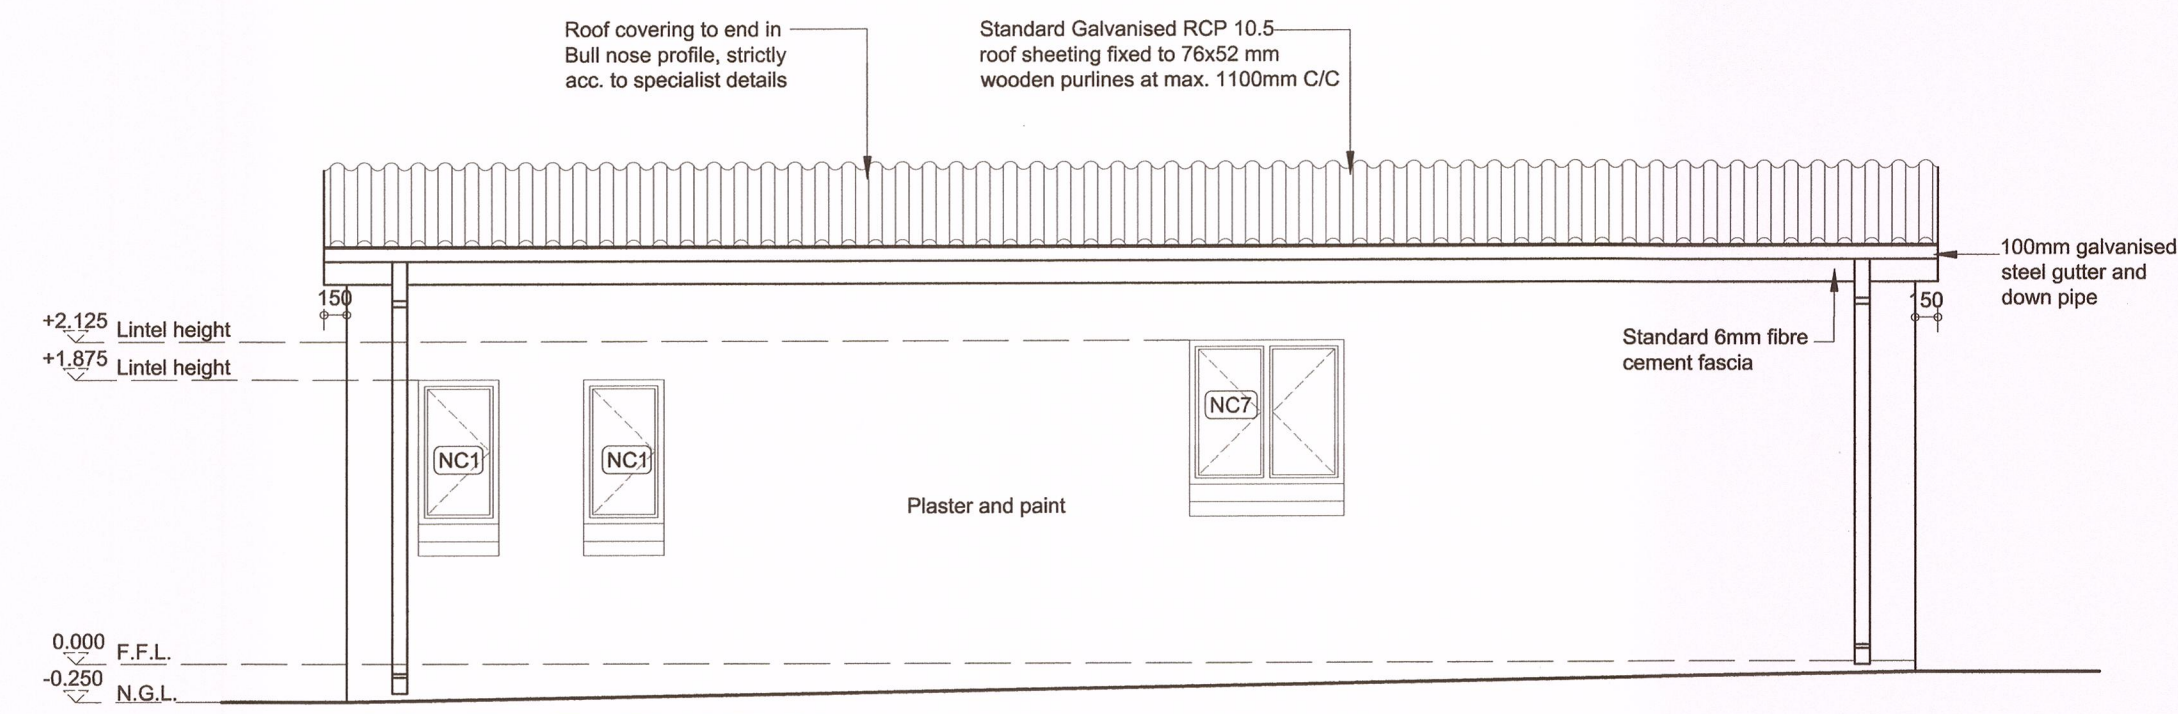


SOUTH ELEVATION
SCALE 1:50

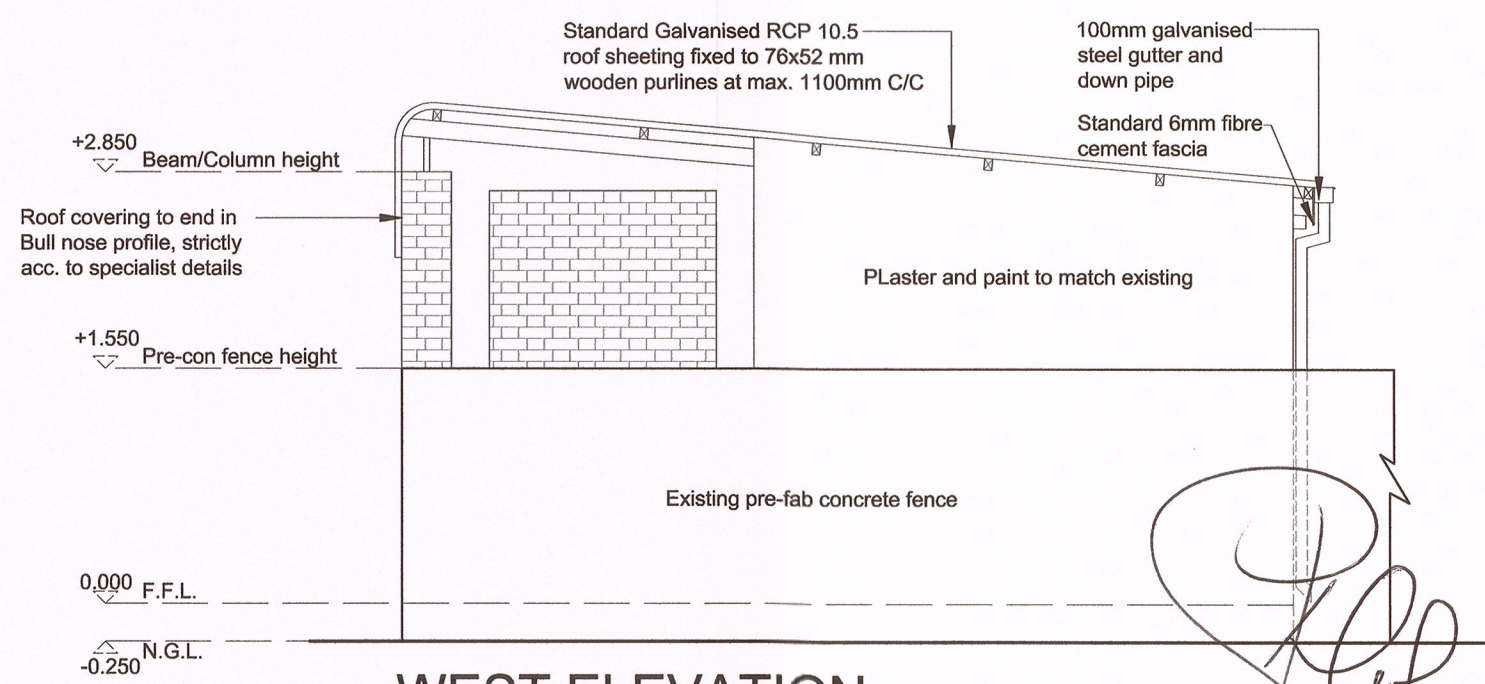

WEST ELEVATION
SCALE 1:50

NOTES
All dimensions on the drawings must be verified against the existing site conditions before the commencement of any work.
Drawings may not be scaled.
The vertical dimensions of brickwork are based on multiple centre lines of 85mm and the contractor must set out brickwork accordingly.
The contractor is responsible for site inspections by the building inspectors of the local authorities.
Except where otherwise indicated all given levels are unfinished levels.
The copyright of this drawing vests in the architect unless otherwise indicated.
All work must be done according to the South African Bureau of Standards code of practice SANS 10400-2010.

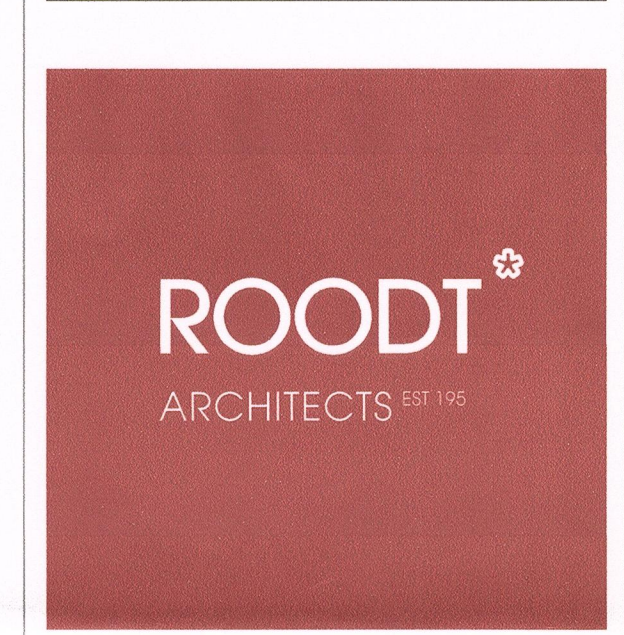

ARCHITECTS EST 1952
ARCHITECTURE, URBAN DESIGN, URBAN PLANNING, INTERIOR DESIGN
ENVIRONMENTAL MANAGEMENT & HERITAGE CONSULTING
7 RAY CHAMPION AVENUE, LILYVALE, BLOEMFONTEIN, 9301
PO BOX 28278, DANHOOF, 9010
TEL: 051 408 2100, FAX: 051 408 2101
info@roodtarchitects.co.za, www.roodtarchitects.co.za

CLIENT
PAN CYPRIOT CC.

PROJECT
RECORD DRAWINGS OF ALL BUILDINGS ON ERF 268, PRES. STEYN STREET 43, WESTDENE BLOEMFONTEIN

DRAWING
EXISTING BRAAI AREA SECTION A-A ELEVATIONS AND BRAAI DETAIL

DESIGN	DATE
N/A	
DRAWN	DATE
KG	25/01/2018
APPROVED	DATE
SCALE	ISSUED
1:10/1:50	12/W1/2018
DRAWING STATUS	DRAWING No.
RECORD DRAWINGS	1074_2/W1/03