


SECTION A-A
SCALE 1:50

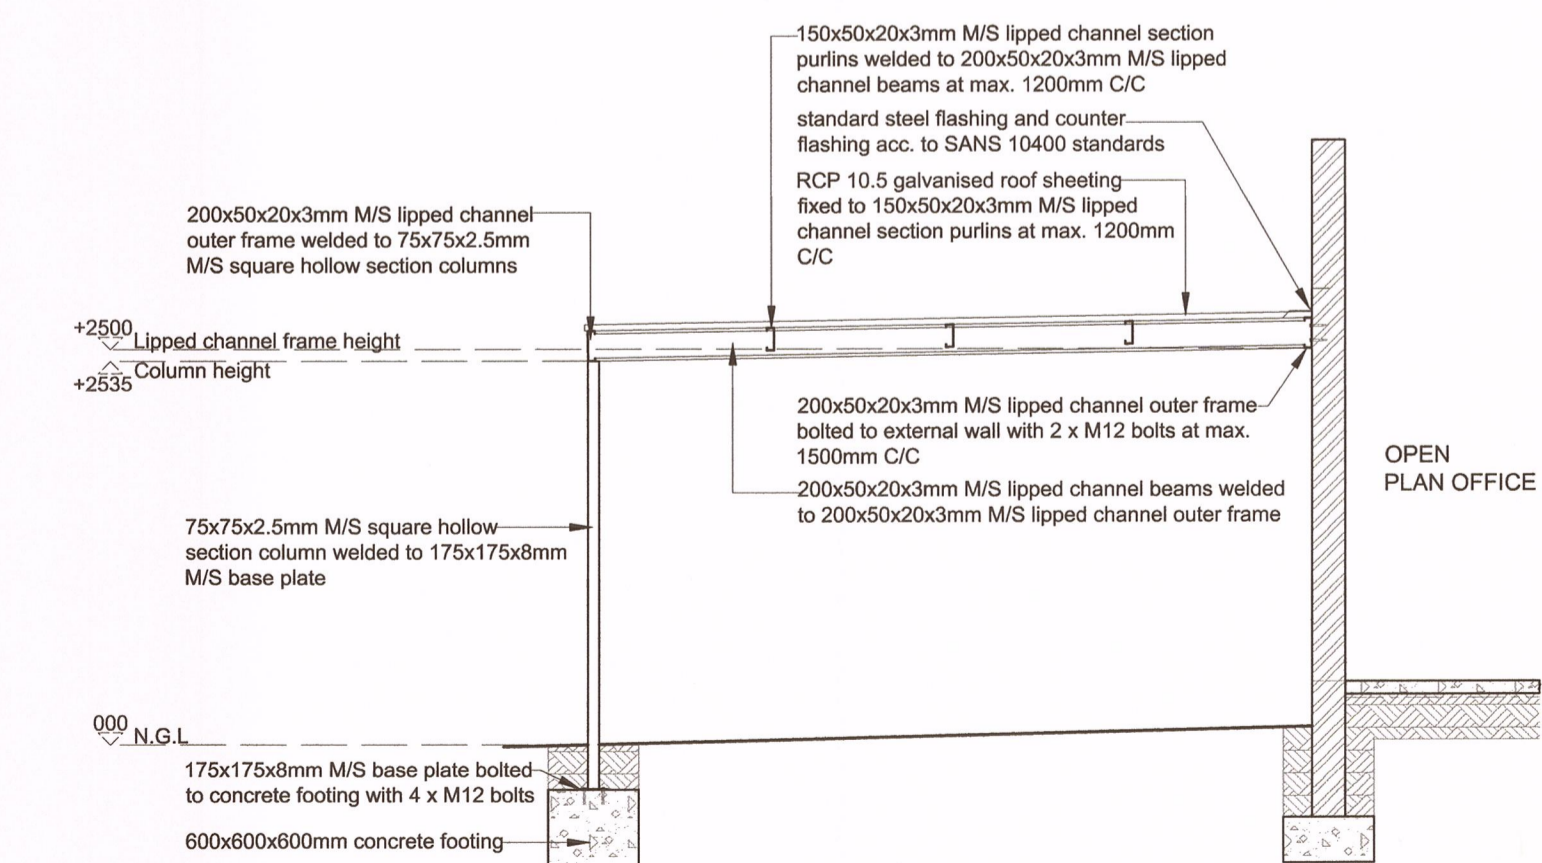

SECTION B-B
SCALE 1:50

| GROUND STOREY WINDOW SCHEDULE | | |
|-------------------------------|---|---|
| | | |
| NUMBER ON PLAN | NC1 | NC4 |
| QUANTITY | 4 | 3 |
| TYPE | standard NC1 aluminium window frame with 1x opening out section. All glazing to be Single obscured glazing acc. to fenestration elements elsewhere and acc. to SANS 10400 AAAMSA and SANS 204 standards | standard NC4 steel window frame with 2 x opening out sections and 1 fixed panel. All glazing to be Single obscured glazing acc. to fenestration elements elsewhere and acc. to SANS 10400 AAAMSA and SANS 204 standards |
| FINISH | prepared with 1 x layer red oxide factory primer and finished with 2 x layers gloss enamel paint | prepared with 1 x layer red oxide factory primer and finished with 2 x layers gloss enamel paint |
| IRONMONGERY | as per manufacturer | as per manufacturer |
| LOCATION | toilets and kitchen | open plan office |
| SILL | Plastered window sill | Plastered window sill |
| LINTEL | 2 x concrete lintels above | 2 x concrete lintels above |


MANGALING METRO MUNICIPALITY
ECONOMIC DEVELOPMENT AND PLANNING DIRECTORATE
LAND USE CONTROL SUB-DIRECTORATE
Recommended for approval
Nwabe Tsh
Building Control Officer / Delegates
This application has been approved in terms of Section 7(1)(a) of Act 103 of 1977, subject to the conditions in the attached letter of recommendation.
GENERAL MANAGER: LAND USE CONTROL DATE 21/03/2018
PLAN NO: 941/2001-2002

| GROUND STOREY DOOR SCHEDULE | | | |
|-----------------------------|--|---|--|
| | | | |
| NUMBER ON PLAN | D01 | D02 | D03 |
| QUANTITY | 1 x RH | 1x LH | 1 x RH 1 x LH TOT. 2 |
| TYPE | standard steel single door door frame for 220mm wall | Standard steel door frame for a 220mm internal wall complete with Semi Solid Vertical Slatted Door complete with 15mm thick solid meranti slats and a centre skeleton with 2 concealed edges. | standard aluminium door frame for new drywall complete with masonite door |
| FINISH | frame = factory primer, 1x universal undercoat and 2x coats gloss enamel (white) | Door: 2 x coats clear varnish Door frame: prime and paint | frame: natural anodized door: 2 x coats gloss enamel (white) |
| IRONMONGERY | 1 x 2 lever lockset complete with s/s handles from dcisa 1 x s/s floor mounted door stop (geze, 140/69) | Acc. to ironmongery specialist like Dorma or other similar approved | 1 x 2 lever lockset complete with s/s handles from dcisa 1 x s/s floor mounted door stop (geze, 140/69) |
| LINTEL | 2 x concrete lintels over | 2 x concrete lintels above | N/A |

NOTES

All dimensions on the drawings must be verified against the existing site conditions before the commencement of any work.
Drawings may not be scaled.
The vertical dimensions of brickwork are based on multiple centre lines of 85mm and the contractor must set out brickwork accordingly.
The contractor is responsible for site inspections by the building inspectors of the local authorities.
Except where otherwise indicated all given levels are unfinished levels.
The copyright of this drawing vests in the architect unless otherwise indicated.
All work must be done according to the South African Bureau of Standards code of practice SANS 10400-2010.

| NO. | REVISION | DATE | APPROVED |
|-----|----------|------|----------|
| | | | |

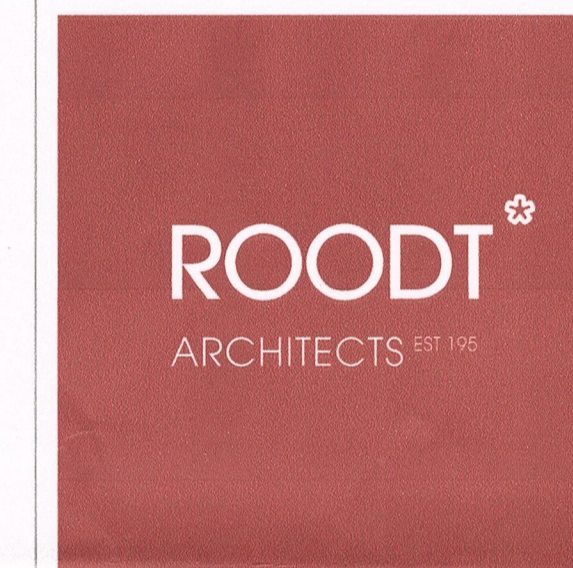

ARCHITECTS EST 1982
ARCHITECTURE, URBAN DESIGN, URBAN PLANNING, INTERIOR DESIGN
ENVIRONMENTAL MANAGEMENT & HERITAGE CONSULTING
7 RAY CHAMPION AVENUE, LILLYVALE, BLOEMFONTEIN, 9301
PO BOX 28278, DANHOF, 9310
TEL: 051 406 2100, FAX: 051 408 2101
info@roodtarchitects.co.za, www.roodtarchitects.co.za

PAN CYPRIOT CC. CLIENT

RECORD DRAWINGS FOR ALL BUILDINGS ON ERF 1/268, PRES. STEYN STREET 45, WESTDENE BLOEMFONTEIN

SECTIONS A-A AND B-B AND WINDOW AND DOOR SCHEDULE

| DESIGN | DATE |
|-----------------|--------------|
| N/A | |
| DRAWN | DATE |
| KG | 25/01/2018 |
| APPROVED | DATE |
| | |
| SCALE | ISSUED |
| 1:100 | 12/02/2018 |
| DRAWING STATUS | DRAWING NO |
| RECORD DRAWINGS | 1074_3/W1/04 |