


MANAGING METRO MUNICIPALITY  
ECONOMIC DEVELOPMENT AND PLANNING DIRECTORATE  
LAND USE CONTROL SUBDIRECTORATE  
Recommended for approval  
Ntsike Tshu  
Building Control Officer / Registrar  
This application has been approved in terms of Section 31(a) of Act 103 of 1977, subject to the conditions in the attached letter of recommendation.  
10/5/2011  
GENERAL MANAGER: LAND USE CONTROL  
DATE  
PLAN NO: 1939/2010-2011

*Handwritten signature*

**NOTES**

All dimensions on the drawings must be verified against the existing site conditions before the commencement of any work.  
Drawings may not be scaled.  
The vertical dimensions of brickwork are based on multiple centre lines of 65mm and the contractor must set out brickwork accordingly.  
The contractor is responsible for site inspections by the building inspectors of the local authorities.  
Except where otherwise indicated all given levels are unfinished levels.  
The copyright of this drawing vests in the architect unless otherwise indicated.  
All work must be done according to the South African Bureau of Standards' code of practice SANS 10400-2010.

No.	REVISION	DATE	APPROVED

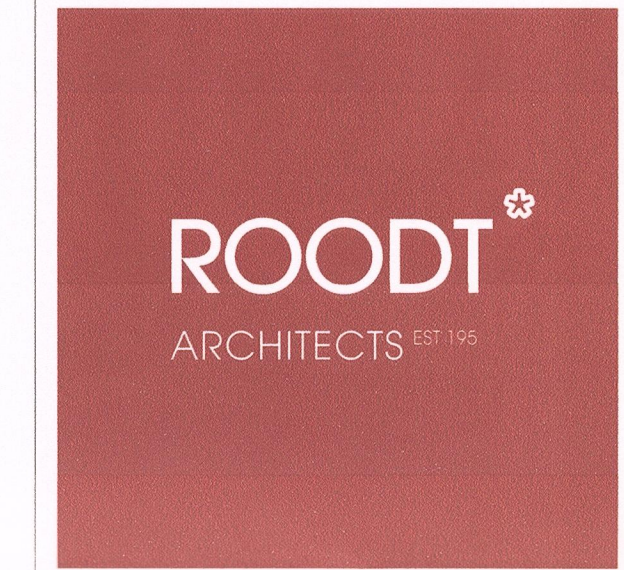

ARCHITECTS EST 1962  
ARCHITECTURE, URBAN DESIGN, URBAN PLANNING, INTERIOR DESIGN  
ENVIRONMENTAL MANAGEMENT & HERITAGE CONSULTING  
7 RAY CHAMPION AVENUE, LILYVALE, BLOEMFONTEIN, 9301  
PO BOX 28278, DANHOFF, 9310  
TEL: 051 406 2100, FAX: 051 406 2101  
info@roodtarchitects.co.za, www.roodtarchitects.co.za

PAN CYPRIOT CC. CLIENT

RECORD DRAWINGS OF ALL BUILDINGS ON ERF 267, PRES. STEYN STREET 47, WESTDENE BLOEMFONTEIN PROJECT

**SECTIONS**

DESIGN	DATE
N/A	
DRAWN	DATE
KG	25/01/2018
APPROVED	DATE
SCALE	ISSUED
1:50	12/02/2018
DRAWING STATUS	DRAWING NO.
RECORD DRAWINGS	1074_4/W/1/05