


GROUND STOREY WINDOW SCHEDULE	
NUMBER ON PLAN	NE1
QUANTITY	2
TYPE	standard NE1 steel window frame with 1 x opening out section All glazing to be Single obscured glazing acc. to fenestration elements elsewhere and acc. to SANS 10400 AAAMSA and SANS 204 standards prepared with 1 x layer red oxide factory primer and finished with 2 x layers gloss enamel paint
FINISH	as per manufacturer
IRONMONGERY	toilet
LOCATION	Plastered window sill
SILL	2 x concrete lintels above
LINTEL	2 x concrete lintels above
DOOR SCHEDULE	
NUMBER ON PLAN	D01
QUANTITY	1 x LH 3 x RH TOT: 4
TYPE	standard steel single door door frame for 220mm wall
FINISH	frame = factory primer, 1x universal undercoat and 2x coats gloss enamel (white) 1 x 2 lever lockset complete with s/s handles from dcisa 1 x s/s floor mounted door stop (geze, 140/69)
IRONMONGERY	2 x concrete lintels over
LINTEL	

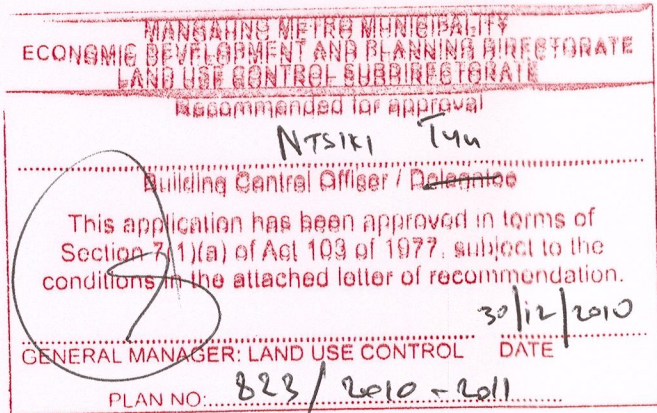

*Handwritten signature*

NOTES

All dimensions on the drawings must be verified against the existing site conditions before the commencement of any work.

Drawings may not be scaled.

The vertical dimensions of brickwork are based on multiple centre lines of 85mm and the contractor must set out brickwork accordingly.


The contractor is responsible for site inspections by the building inspectors of the local authorities.

Except where otherwise indicated all given levels are unfinished levels.

The copyright of this drawing vests in the architect unless otherwise indicated.

All work must be done according to the South African Bureau of Standard's code of practice SANS 10400-2010.

NO.	REVISION	DATE	APPROVED

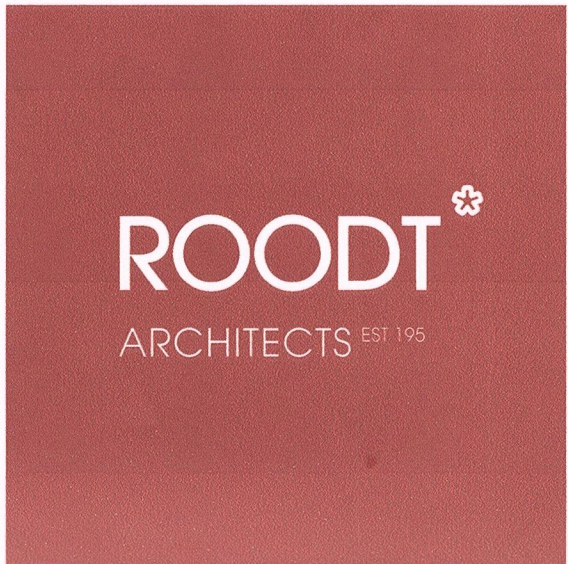

ARCHITECTS EST 1952

ARCHITECTURE, URBAN DESIGN, URBAN PLANNING, INTERIOR DESIGN  
ENVIRONMENTAL MANAGEMENT & HERITAGE CONSULTING

7 RAY CHAMPION AVENUE, LILYVALE, BLOEMFONTEIN, 9301  
PO BOX 28278, DANHOF, 9310  
TEL: 051 406 2100, FAX: 051 406 2101  
info@roodtarchitects.co.za, www.roodtarchitects.co.za

PAN CYPRIOT CC.

RECORD DRAWINGS OF ALL BUILDINGS ON ERF 1/267, PRES. STEYN STREET 49, WESTDENE BLOEMFONTEIN

GROUND AND FIRST FLOOR PLAN AS WELL AS WINDOW AND DOOR SCHEDULE

DESIGN	DATE
N/A	
DRAWN	DATE
KG	25/01/2018
APPROVED	DATE
SCALE	ISSUED
1:100	12/02/2018
DRAWING STATUS	DRAWING NO.
RECORD DRAWINGS	1074_5/W1/02