




SECTION D-D  
SCALE 1:50

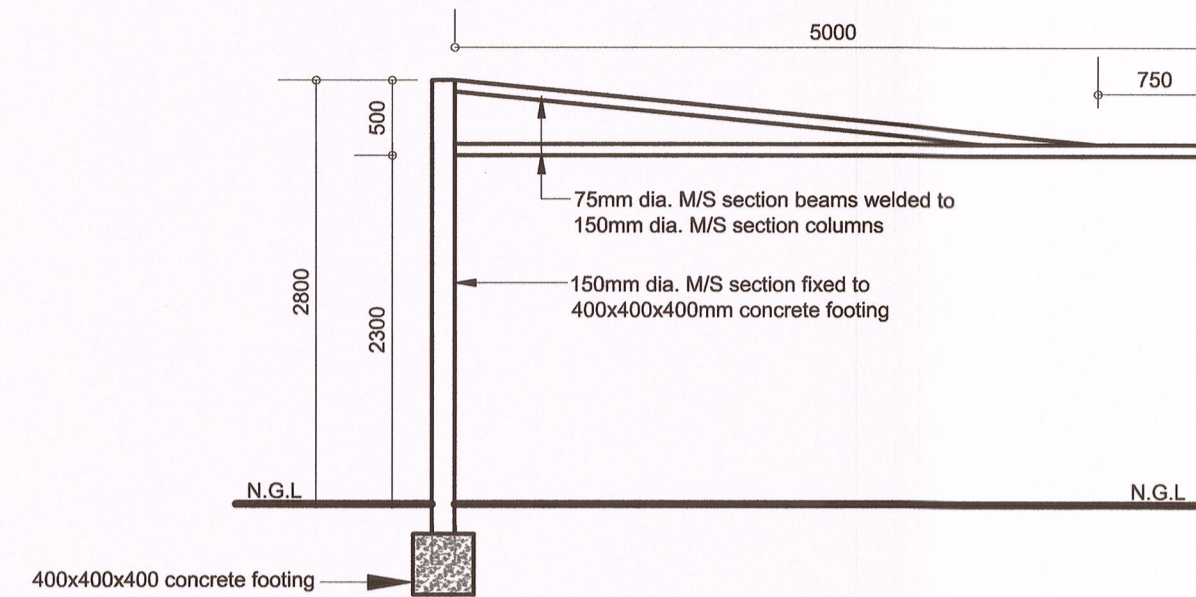


SECTION B-B  
SCALE 1:50

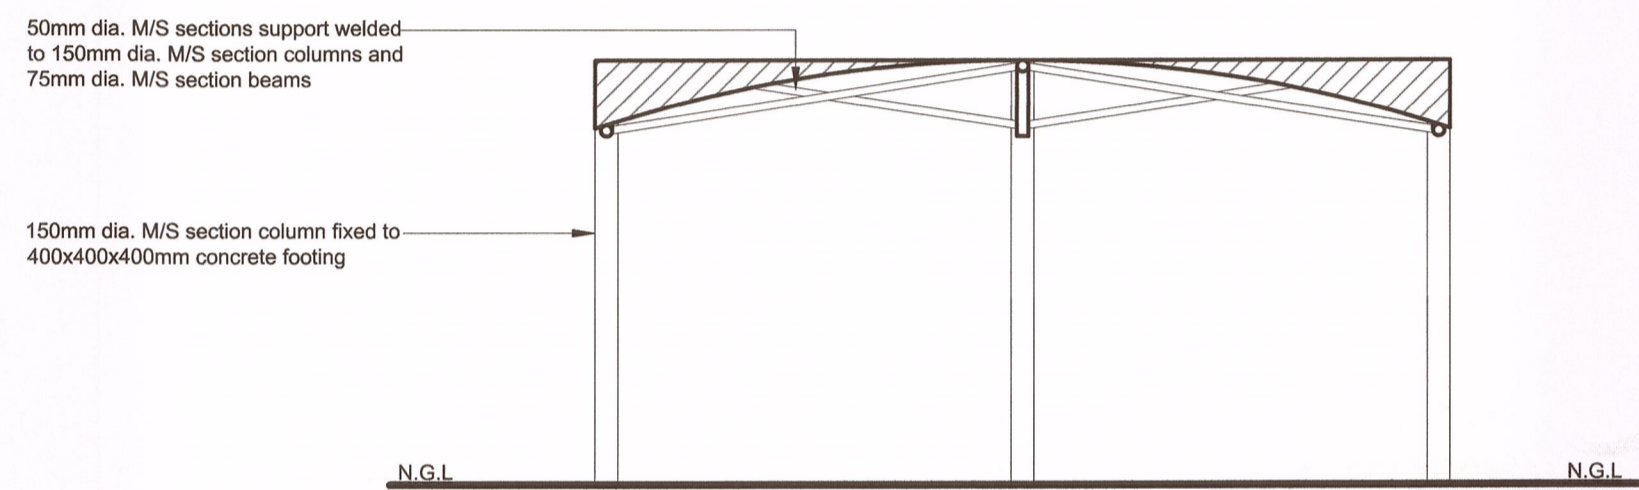

VIEW A  
SCALE 1:50

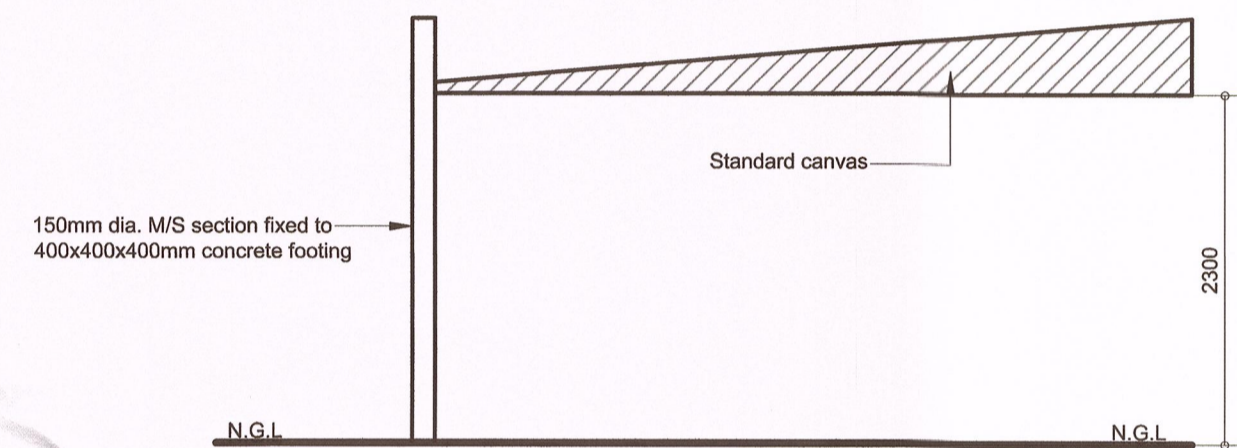

VIEW B  
SCALE 1:50

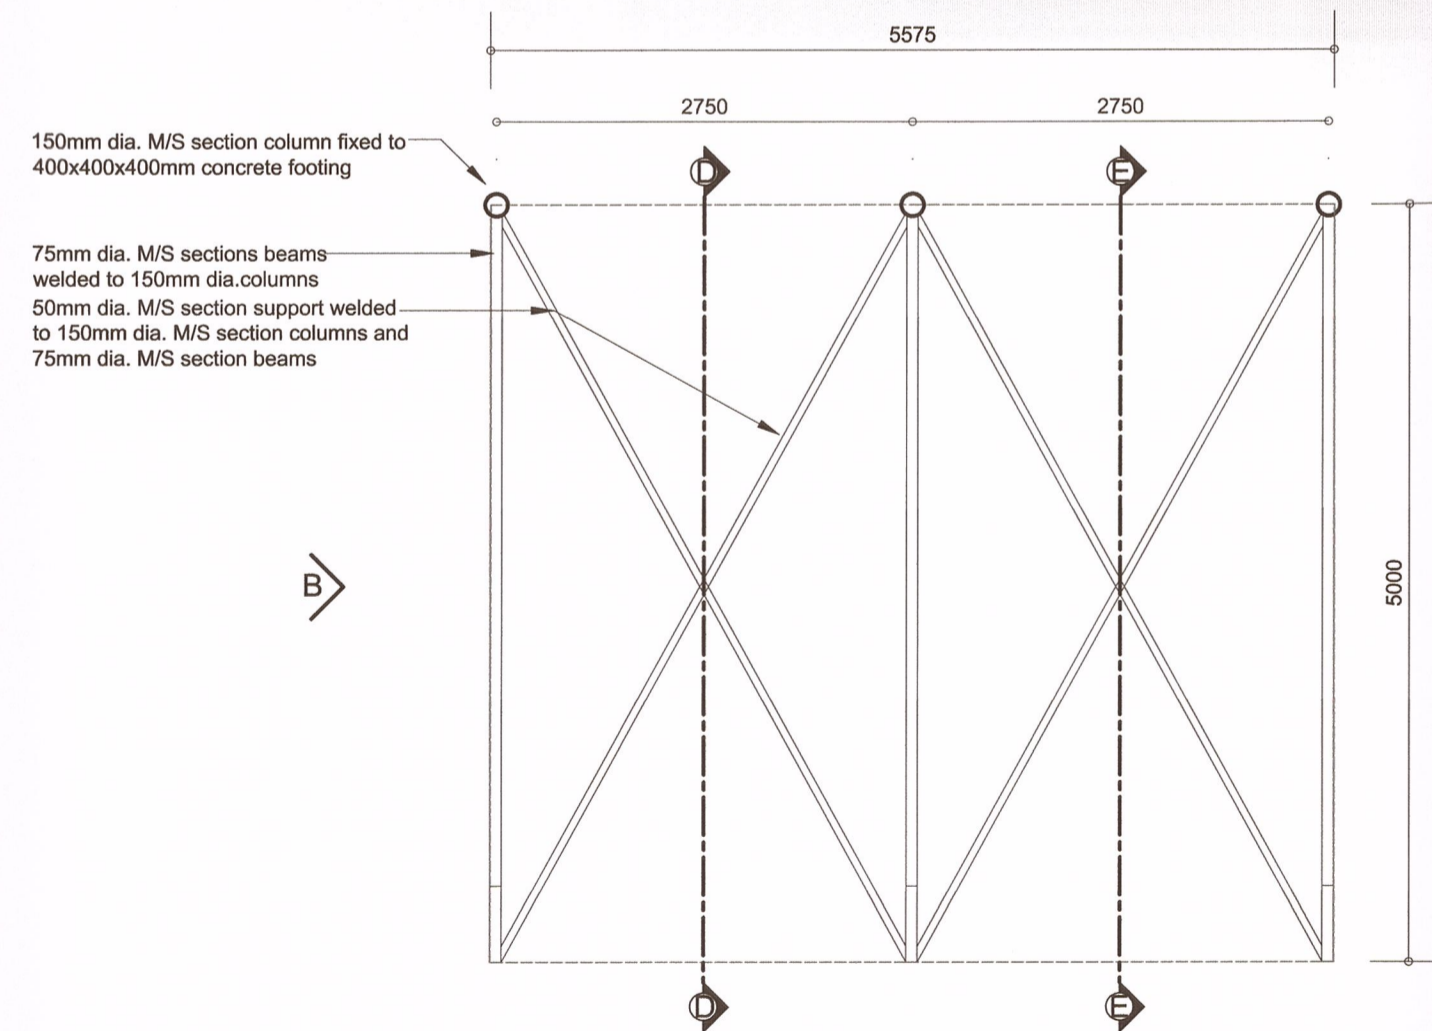

SHADEPORT C: VLOORPLAN  
SCALE 1:50


MANISAURIS METRO MUNICIPALITY  
ECONOMIC DEVELOPMENT AND PLANNING DIRECTORATE  
LAND USE CONTROL SUBDIRECTORATE  
Recommended for approval  
Mrs. T. M. ...  
Building Control Officer / Directorate  
This application has been approved in terms of  
Section 7(1)(a) of Act 103 of 1977, subject to the  
conditions in the attached letter of recommendation.  
30/11/2010  
GENERAL MANAGER: LAND USE CONTROL DATE  
PLAN NO. 883/2010-2011

*[Handwritten signature]*

NOTES

All dimensions on the drawings must be verified against the existing site conditions before the commencement of any work.  
Drawings may not be scaled.  
The vertical dimensions of brickwork are based on multiple centre lines of 85mm and the contractor must set out brickwork accordingly.  
The contractor is responsible for site inspections by the building inspectors of the local authorities.  
Except where otherwise indicated all given levels are unfinished levels.  
The copyright of this drawing vests in the architect unless otherwise indicated.  
All work must be done according to the South African Bureau of Standard's code of practice SANS 10400-2010.

No.	REVISION	DATE	APPROVED

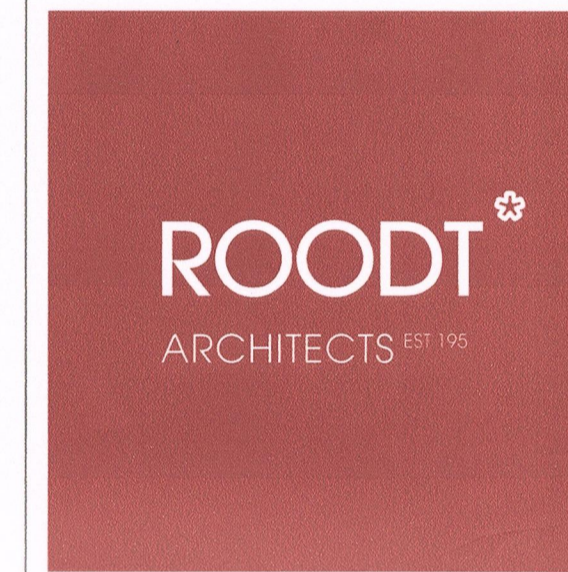

ARCHITECTS EST 1952  
ARCHITECTURE, URBAN DESIGN, URBAN PLANNING, INTERIOR DESIGN  
ENVIRONMENTAL MANAGEMENT & HERITAGE CONSULTING  
7 RAY CHAMPION AVENUE, LILYVALE, BLOEMFONTEIN, 9301  
PO BOX 28278, DANHOF, 9310  
TEL: 051 406 2100, FAX: 051 406 2101  
info@roodtarchitects.co.za, www.roodtarchitects.co.za

PAN CYPRIOT CC.

RECORD DRAWINGS OF ALL  
BUILDINGS ON ERF 1/267, PRES.  
STEYN STREET 49, WESTDENE  
BLOEMFONTEIN

SHADEPORT PLAN, SECTIONS  
AND ELEVATIONS

DESIGN	DATE
N/A	
DRAWN	DATE
KG	25/01/2018
APPROVED	DATE
SCALE	ISSUED
1:50	12/02/2018
DRAWING STATUS	DRAWING No
RECORD DRAWINGS	1074_5/W1/06