

GROUND STOREY WINDOW SCHEDULE			
NUMBER ON PLAN	W1	W2	W3
QUANTITY	2	2	1
TYPE	Standard pt69 aluminium window, 1x opening up section and 1x fixed panel. All glazing to be Single obscured glazing acc. to fenestration elements elsewhere and acc. to SANS 10400 AAAMSA and SANS 204 standards	Standard pt69 aluminium window with fixed panel. All glazing to be Single obscured glazing acc. to fenestration elements elsewhere and acc. to SANS 10400 AAAMSA and SANS 204 standards	Purpose made aluminium window, 1x opening up section and 1x fixed panel. All glazing to be Single obscured glazing acc. to fenestration elements elsewhere and acc. to SANS 10400 AAAMSA and SANS 204 standards
FINISH	Powder coated, colour Bronze	Powder coated, colour Bronze	Powder coated, colour Bronze
IRONMONGERY	as per manufacturer	as per manufacturer	as per manufacturer
LOCATION	Class room	Class room	Class room
SILL	painted brick-on-edge sill	painted brick-on-edge sill	painted brick-on-edge sill
LINTEL	2 x concrete lintels above	2 x concrete lintels above	2 x concrete lintels above

GROUND STOREY WINDOW SCHEDULE			
NUMBER ON PLAN	W4	W5	W6
QUANTITY	1	1	1
TYPE	Purpose made aluminium window with fixed panel. All glazing to be Single obscured glazing acc. to fenestration elements elsewhere and acc. to SANS 10400 AAAMSA and SANS 204 standards	Purpose made aluminium door with fixed side panel. All glazing to be Single obscured glazing acc. to fenestration elements elsewhere and acc. to SANS 10400 AAAMSA and SANS 204 standards	Purpose made aluminium door with fixed panels. All glazing to be Single obscured glazing acc. to fenestration elements elsewhere and acc. to SANS 10400 AAAMSA and SANS 204 standards
FINISH	Powder coated, colour Bronze	Powder coated, colour Bronze	Powder coated, colour Bronze
IRONMONGERY	as per manufacturer	as per manufacturer	as per manufacturer
LOCATION	Reception	Reception	Reception
SILL	painted brick-on-edge sill	none	none
LINTEL	2 x concrete lintels above	2 x concrete lintels above	2 x concrete lintels above

GROUND STOREY WINDOW SCHEDULE			GROUND STOREY DOOR SCHEDULE	
NUMBER ON PLAN	W7	W8	NUMBER ON PLAN	D1
QUANTITY	2	2	QUANTITY	3
TYPE	Standard pt66 aluminium window with opening up section. All glazing to be Single obscured glazing acc. to fenestration elements elsewhere and acc. to SANS 10400 AAAMSA and SANS 204 standards	Standard pt159 aluminium window, 1x opening up section and 2x fixed panel. All glazing to be Single obscured glazing acc. to fenestration elements elsewhere and acc. to SANS 10400 AAAMSA and SANS 204 standards	TYPE	standard steel single door door frame for internal wall
FINISH	Powder coated, colour Bronze	Powder coated, colour Bronze	FINISH	frame = factory primer, 1x universal undercoat and 2x coats gloss enamel (white)
IRONMONGERY	as per manufacturer	as per manufacturer	IRONMONGERY	Acc. to ironmongery specialist like Dorma or other similar approved
LOCATION	bathrooms	kitchenette and class room	LINTEL	1 x concrete lintels over
SILL	painted brick-on-edge sill	painted brick-on-edge sill		
LINTEL	2 x concrete lintels above	2 x concrete lintels above		

MANAUNGU METRO MUNICIPALITY
ECONOMIC DEVELOPMENT AND PLANNING DIRECTORATE
LAND USE CONTROL SUBDIRECTORATE
Recommended for approval
Ntshiki 14
Building Control Officer / Designer
This application has been approved in terms of Section 7(1)(a) of Act 103 of 1977, subject to the conditions in the attached letter of recommendation.
21/02/2018
GENERAL MANAGER: LAND USE CONTROL
DATE
PLAN NO: 1510/Root-Loos

NOTES

All dimensions on the drawings must be verified against the existing site conditions before the commencement of any work.

Drawings may not be scaled.

The vertical dimensions of brickwork are based on multiple centre lines of 85mm and the contractor must set out brickwork accordingly.


The contractor is responsible for site inspections by the building inspectors of the local authorities.

Except where otherwise indicated all given levels are unfinished levels.

The copyright of this drawing vests in the architect unless otherwise indicated.

All work must be done according to the South African Bureau of Standard's code of practice SANS 10400-2010.

NO.	REVISION	DATE	APPROVED

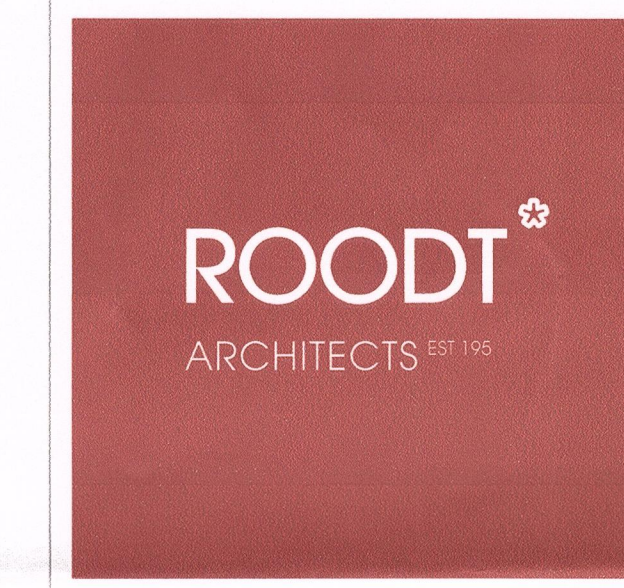

ARCHITECTS EST 1952
ARCHITECTURE, URBAN DESIGN, URBAN PLANNING, INTERIOR DESIGN
ENVIRONMENTAL MANAGEMENT & HERITAGE CONSULTING
7 RAY CHAMPION AVENUE, LILYVALE, BLOEMFONTEIN, 9301
PO BOX 28278, DANHOF, 9310
TEL: 051 406 2100, FAX: 051 406 2101
Info@roodtarchitects.co.za, www.roodtarchitects.co.za

CLIENT
PAN CYPRIOT CC.

PROJECT
RECORD DRAWINGS OF ALL BUILDINGS ON ERF 1/266, PRES. STEYN STREET 51, WESTDENE BLOEMFONTEIN

DRAWING
WINDOW AND DOOR SCHEDULE FOR NEW BUILDING 2

DESIGN	DATE
N/A	
DRAWN	DATE
BF	25/01/2018
APPROVED	DATE
SCALE	ISSUED
1:100	12/02/2018
DRAWING STATUS	DRAWING No
RECORD DRAWINGS	1074_6/W1/03